



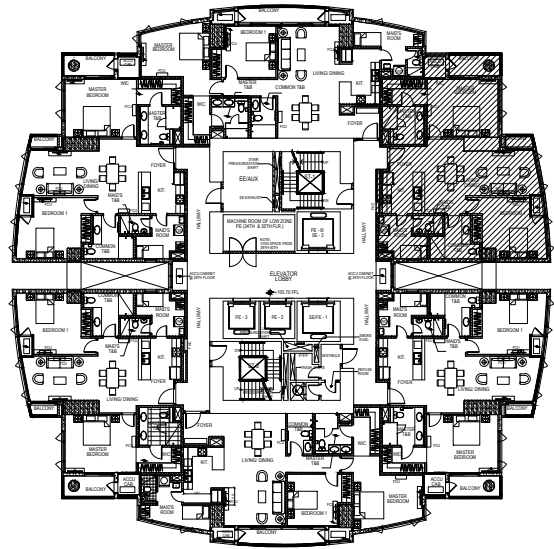

KEY PLAN

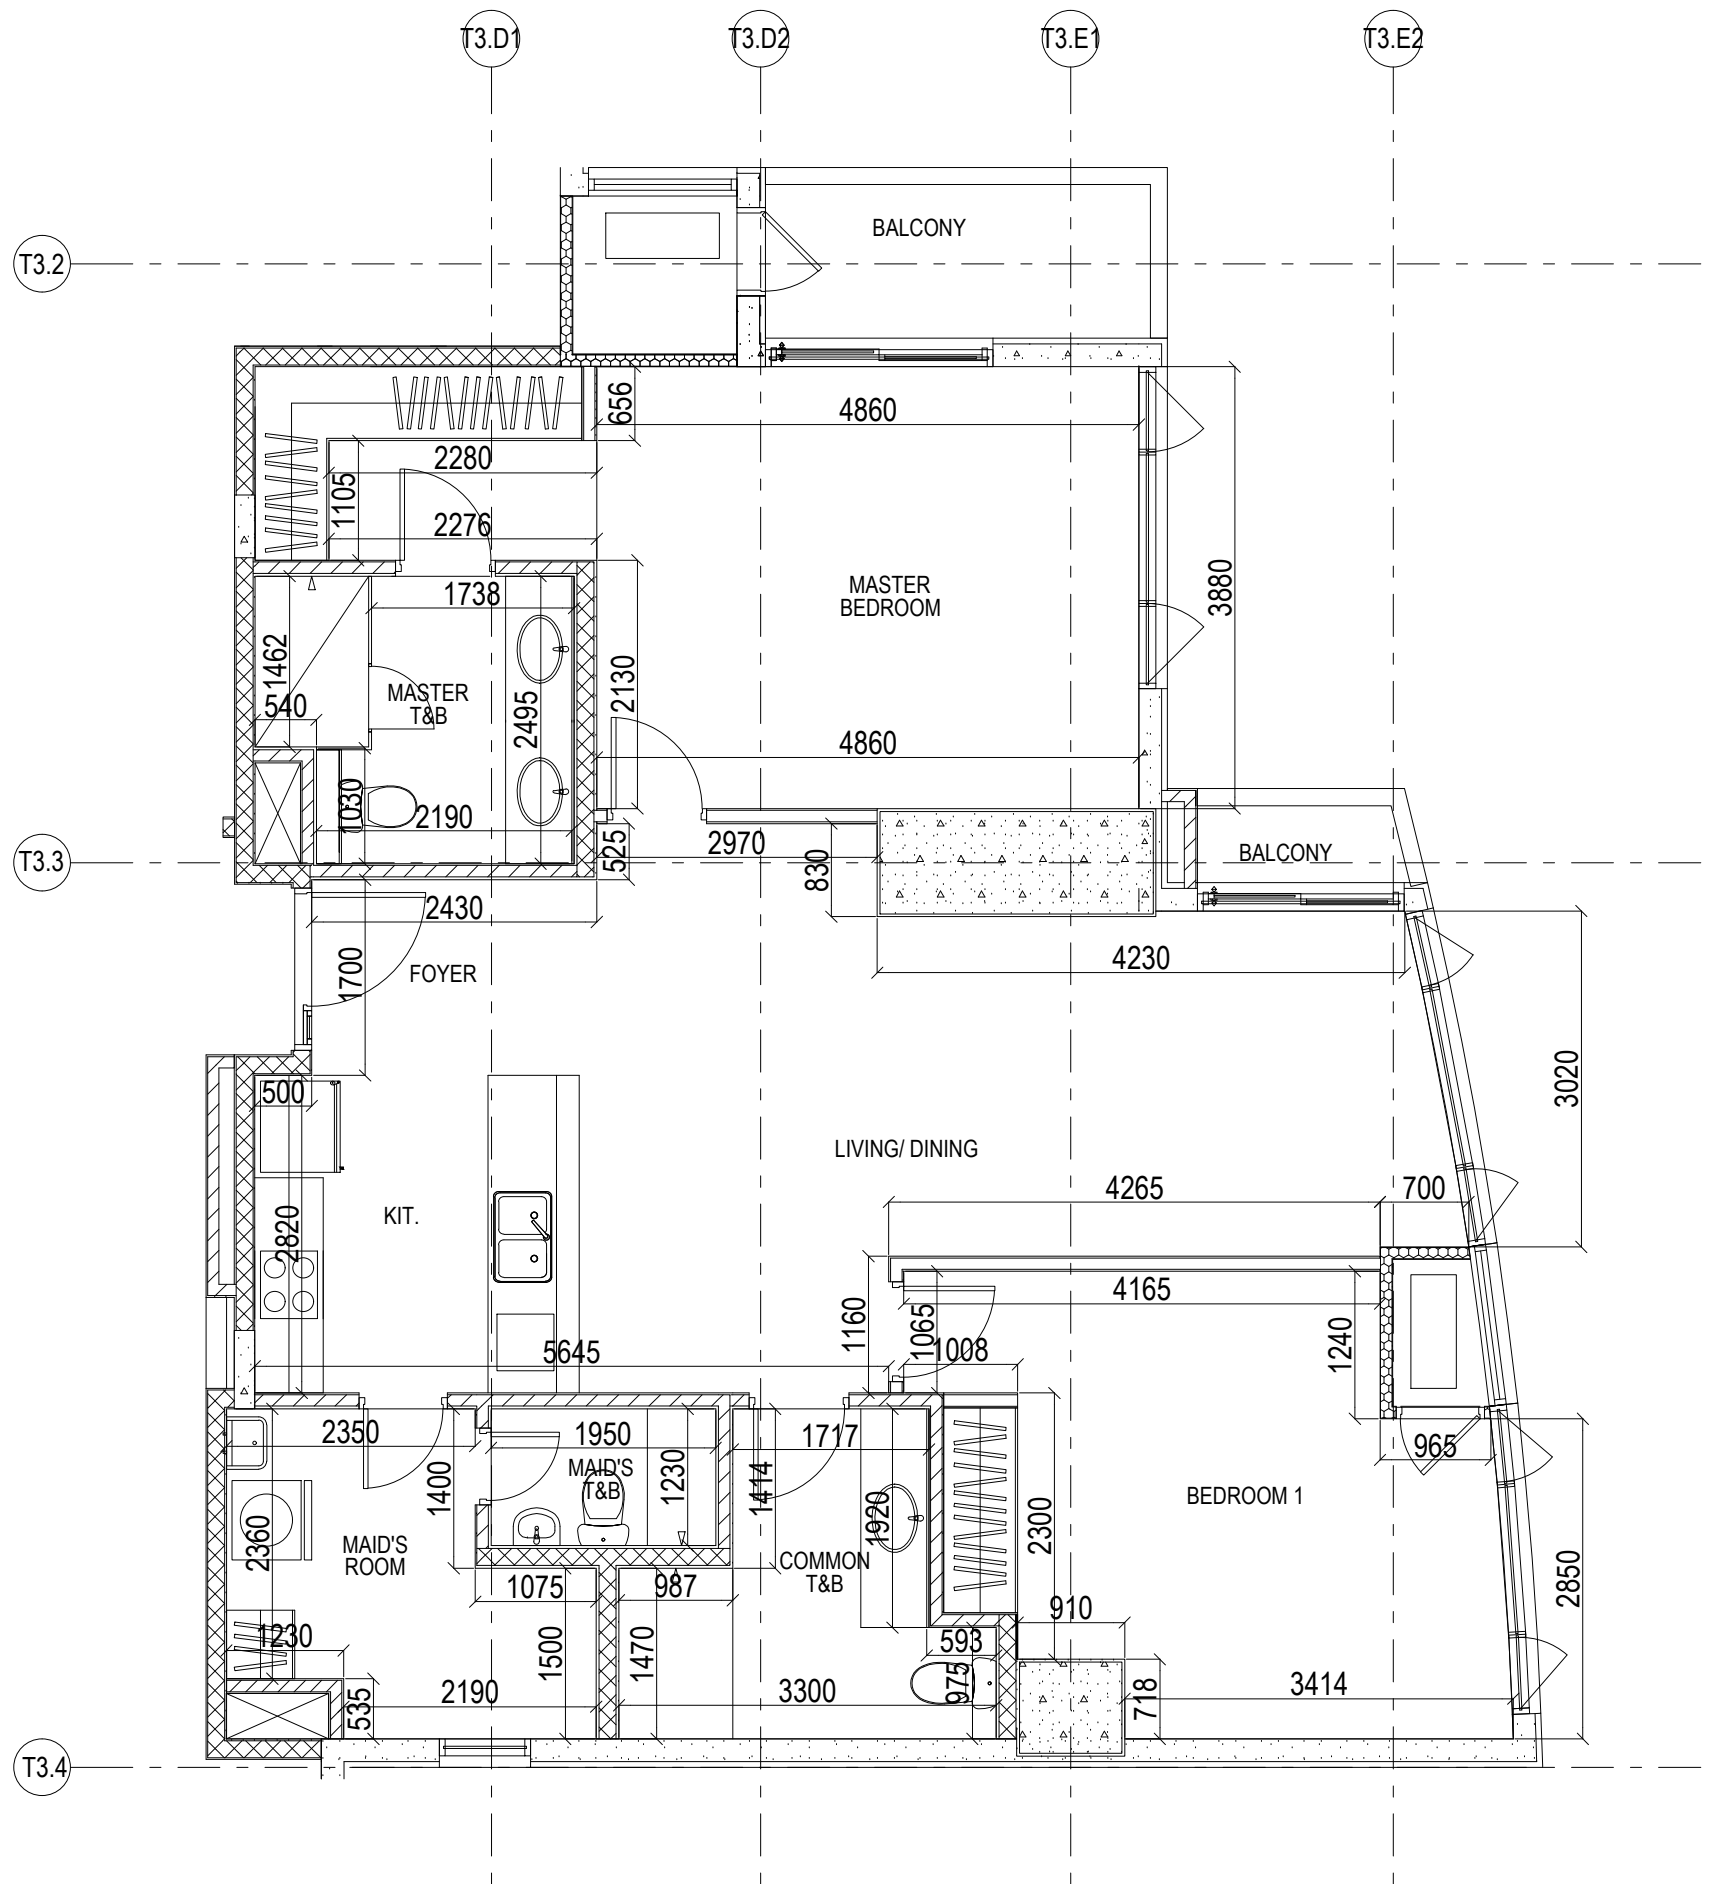


39TH FLOOR PLAN UNIT A/2BR-2.1
ENLARGE FLOOR PLAN

SCALE : 1:70 mtrs



PARK TERRACES POINT TOWER AYALA CENTER, MAKATI CITY, PHILIPPINES

OWNER	Ayala Land Premier 30F Tower 1 & Exchange Plaza, Ayala Triangle, Ayala Avenue, Makati City
PROJECT MANAGER	Makati Development Corp. Ayala-Life FGU Center, Madrigal Business Park, Alabang Zapote Road corner Acacia Avenue, Muntinlupa City
ARCHITECT	Aidea Philippines Inc. 30F Ayala Life FGU Centre, 6811 Ayala Avenue, Salcedo Village 1229, Makati City, Philippines
STRUCTURAL CONSULTANT	SY*2 + ASSOCIATES, INCORPORATED Unit 504 Pryce Center, 1178 Chino Roces cor. Baglikan St., Makati City, Philippines
FIRE PROTECTION CONSULTANT	NBF Consulting Engineers Unit L-14, B2 Lower Ground Floor, Makati Cinema Square Building, Pasong Tamo, Makati City
PLUMBING CONSULTANT	NBF Consulting Engineers Unit L-14, B2 Lower Ground Floor, Makati Cinema Square Building, Pasong Tamo, Makati City
MECHANICAL CONSULTANT	L.R. Punzalan & Associate 2F Lauremar Building, 1458 Newton Street Barangay San Isidro, Makati City
ELECTRICAL CONSULTANT	E.B. Cruz & Associate 1335 A. Mabini St., Kalookan City, Metro Manila
SECURITY MANAGEMENT CONSULTANT	Meinhardt Philippines Inc. 25th Flr. Chatham House 116 Valero cor. V.A. Rufino Sts., Salcedo Village, Makati City
ACOUSTIC CONSULTANT	Meinhardt Philippines Inc. 25th Flr. Chatham House 116 Valero cor. V.A. Rufino Sts., Salcedo Village, Makati City
LIFT CONSULTANT	Meinhardt Philippines Inc. 25th Flr. Chatham House 116 Valero cor. V.A. Rufino Sts., Salcedo Village, Makati City
FACADE CONSULTANT	Meinhardt Facade Technology - Meinhardt Philippines Inc. 25th Flr. Chatham House 116 Valero cor. V.A. Rufino Sts., Salcedo Village, Makati City
QUANTITY SURVEYOR	RLB - Rider Levett Bucknall Suite 2301A East Tower, Phil. Stock Exchange Center, Ortigas Commercial Center, Pasig City

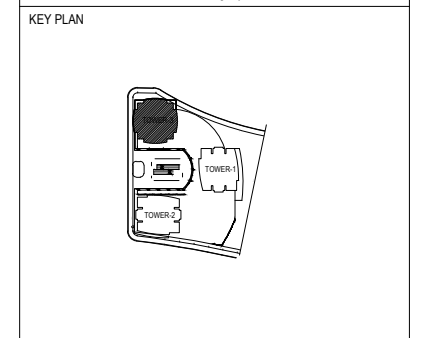

GENERAL CONTRACTOR



Ayala-Life FGU Center, Madrigal Business Park, Alabang-Zapote Road cor. Acacia Avenue, Muntinlupa City

PURPOSE OF ISSUANCE:

AS-BUILT DRAWINGS

NOTED BY: SRP	PROJECT MANAGER		
CHECKED BY: JMSCHUA			
DRAWN BY: GIDP			
DATE OCTOBER 2016	REG. NO. PTR NO. TIN NO.	Date Issued Issued at	
SHEET CONTENTS		DRAWING NO.	
39TH FLOOR UNIT A 2.1 ENLARGE FLOOR PLAN		SCALE AS SHOWN	REV
		PROJ. NO.	